


DRILL HOLES

DRILL HOLES


DRILL HOLES

BORDER REV. DATE: June 1, 2004

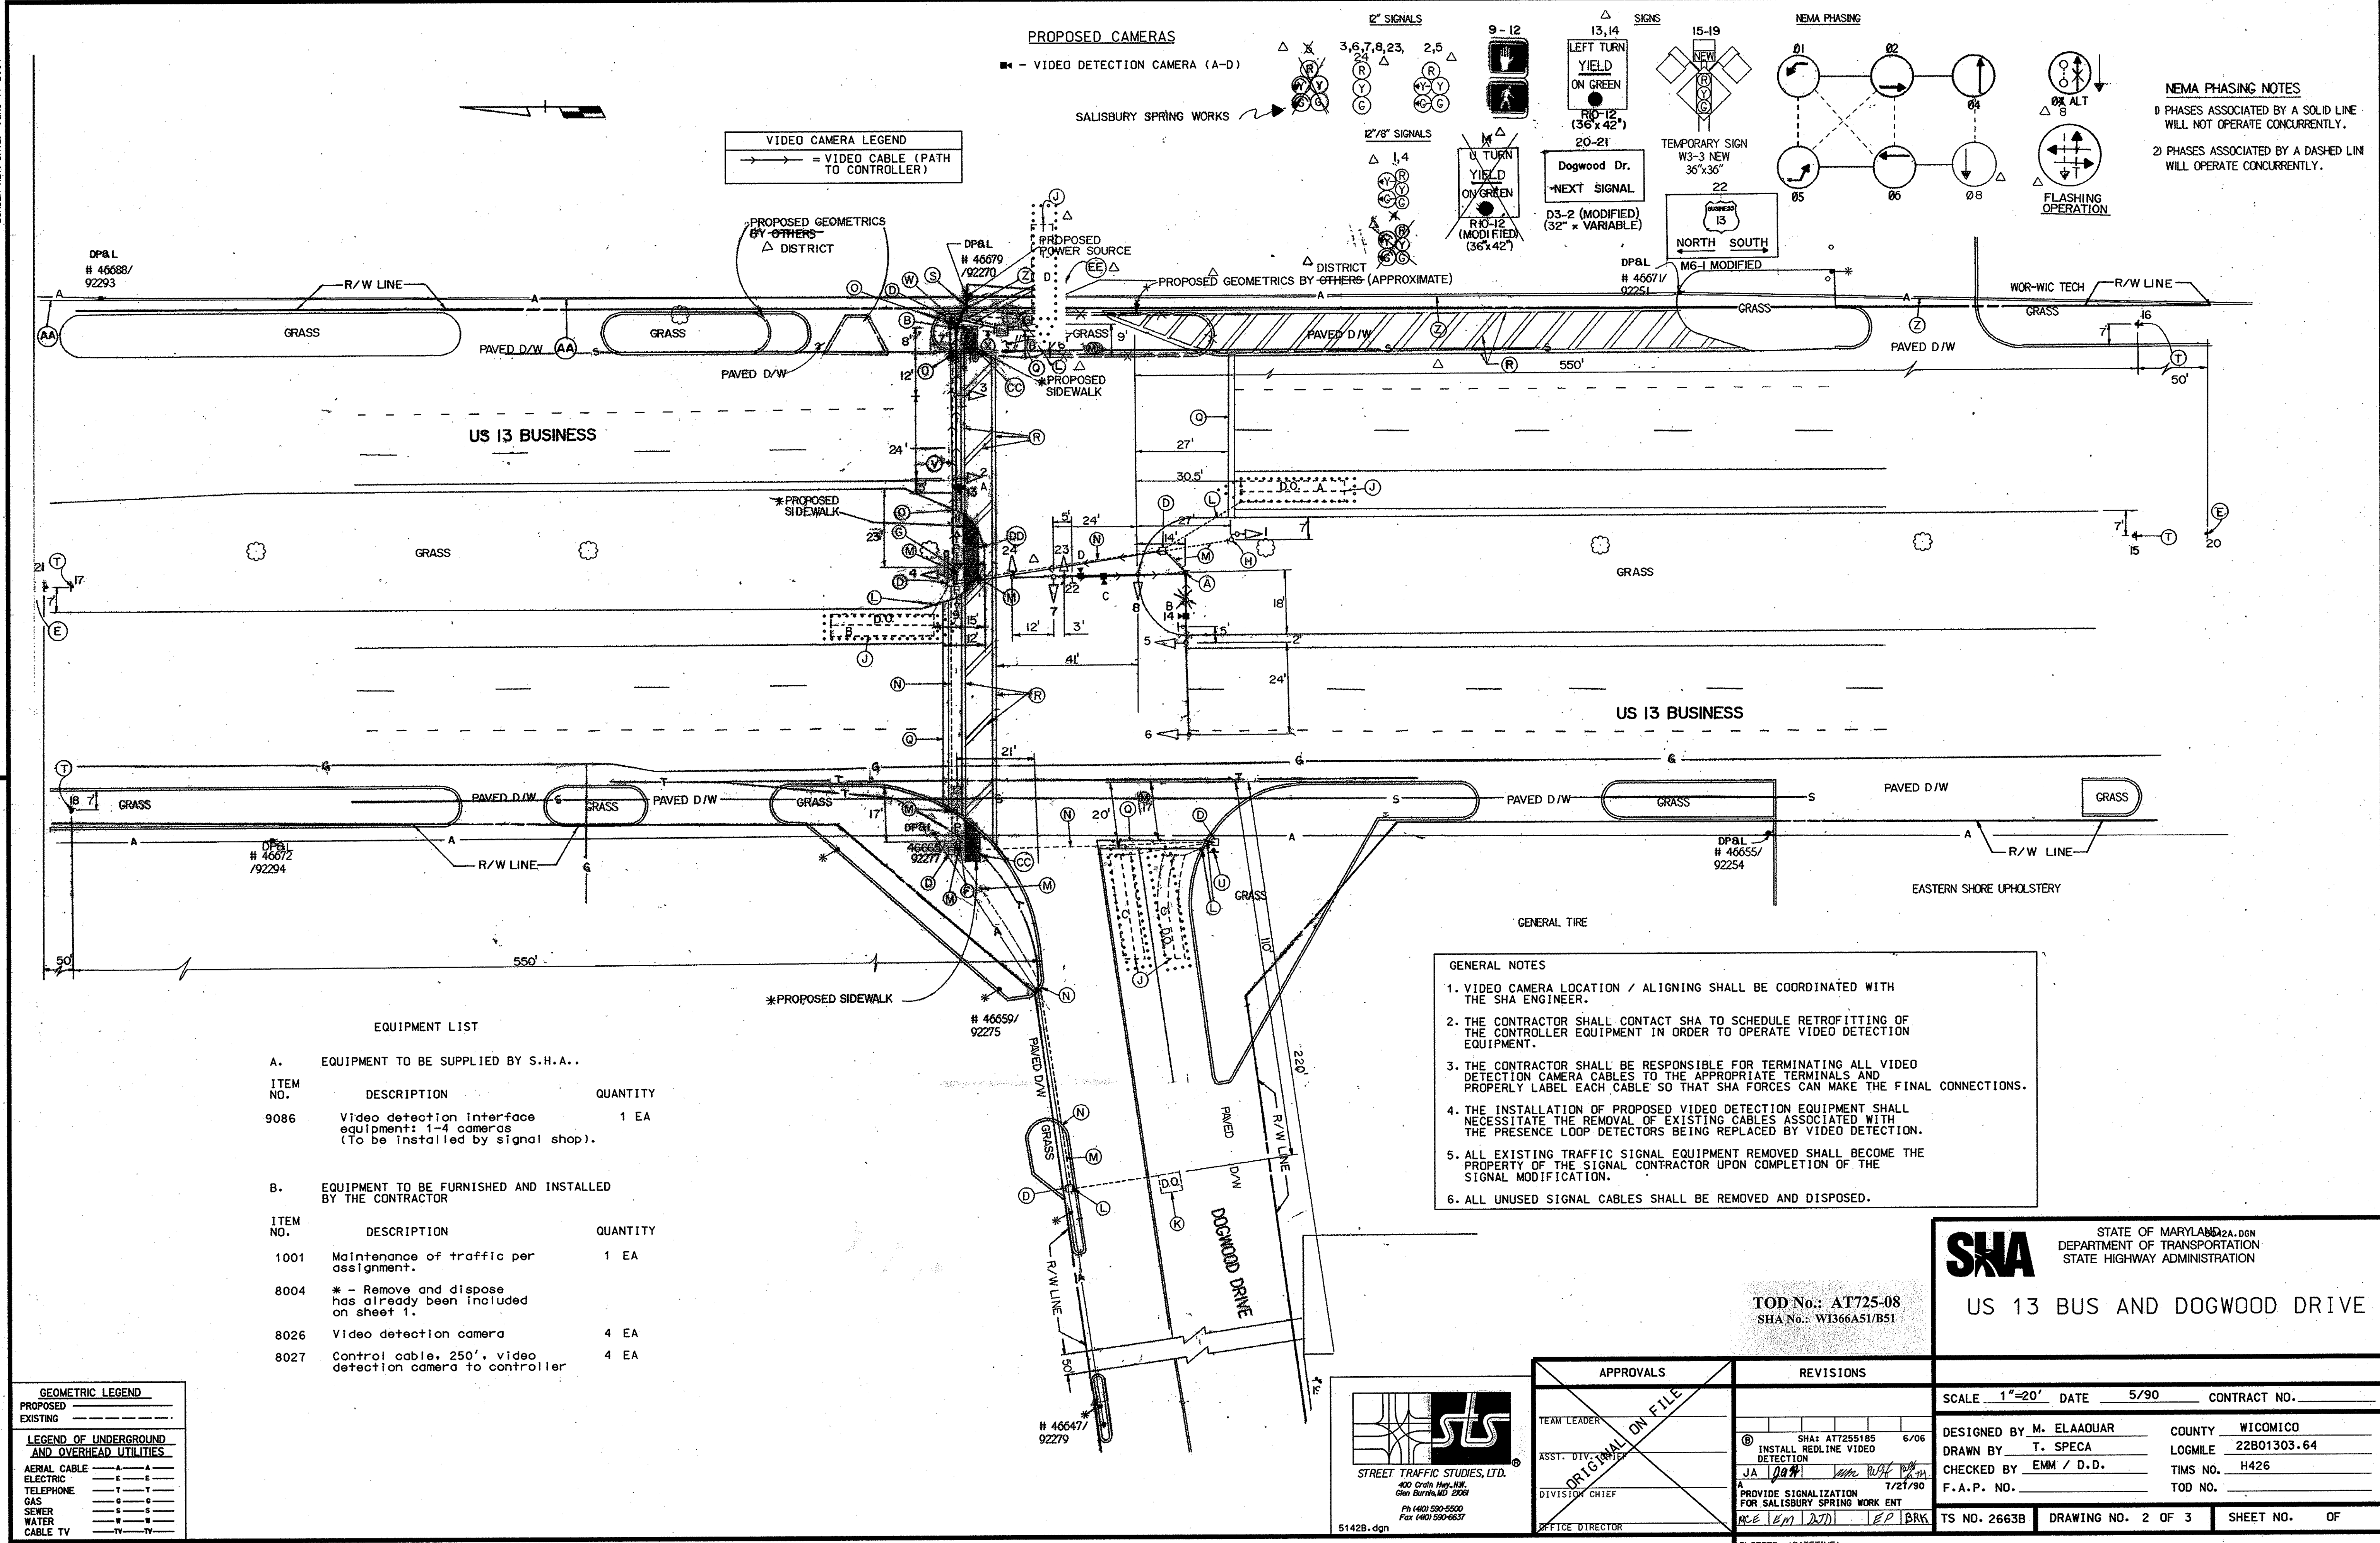

VIDEO CAMERA LEGEND
= VIDEO CABLE (PATH TO CONTROLLER)

PROPOSED CAMERAS
= VIDEO DETECTION CAMERA (A-D)

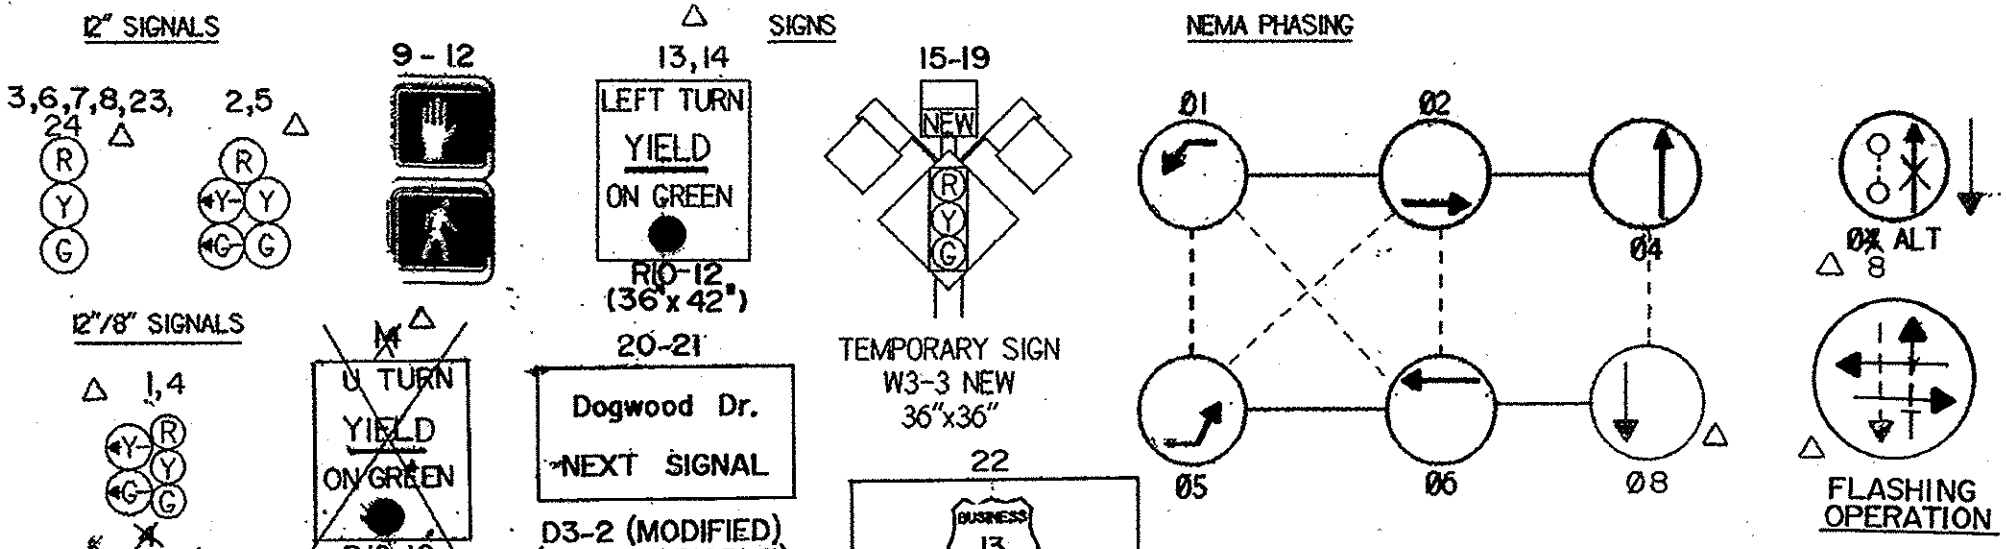


NEMA PHASING NOTES
1 PHASES ASSOCIATED BY A SOLID LINE WILL NOT OPERATE CONCURRENTLY.
2 PHASES ASSOCIATED BY A DASHED LINE WILL OPERATE CONCURRENTLY.

EQUIPMENT LIST		
A. EQUIPMENT TO BE SUPPLIED BY S.H.A..		
ITEM NO.	DESCRIPTION	QUANTITY
9086	Video detection interface equipment: 1-4 cameras (To be installed by signal shop).	1 EA
B. EQUIPMENT TO BE FURNISHED AND INSTALLED BY THE CONTRACTOR		
ITEM NO.	DESCRIPTION	QUANTITY
1001	Maintenance of traffic per assignment.	1 EA
8004	* - Remove and dispose has already been included on sheet 1.	
8026	Video detection camera	4 EA
8027	Control cable, 250', video detection camera to controller	4 EA

GENERAL NOTES
1. VIDEO CAMERA LOCATION / ALIGNING SHALL BE COORDINATED WITH THE SHA ENGINEER.
2. THE CONTRACTOR SHALL CONTACT SHA TO SCHEDULE RETROFITTING OF THE CONTROLLER EQUIPMENT IN ORDER TO OPERATE VIDEO DETECTION EQUIPMENT.
3. THE CONTRACTOR SHALL BE RESPONSIBLE FOR TERMINATING ALL VIDEO DETECTION CAMERA CABLES TO THE APPROPRIATE TERMINALS AND PROPERLY LABEL EACH CABLE SO THAT SHA FORCES CAN MAKE THE FINAL CONNECTIONS.
4. THE INSTALLATION OF PROPOSED VIDEO DETECTION EQUIPMENT SHALL NECESSITATE THE REMOVAL OF EXISTING CABLES ASSOCIATED WITH THE PRESENCE LOOP DETECTORS BEING REPLACED BY VIDEO DETECTION.
5. ALL EXISTING TRAFFIC SIGNAL EQUIPMENT REMOVED SHALL BECOME THE PROPERTY OF THE SIGNAL CONTRACTOR UPON COMPLETION OF THE SIGNAL MODIFICATION.
6. ALL UNUSED SIGNAL CABLES SHALL BE REMOVED AND DISPOSED.

GEOMETRIC LEGEND	
PROPOSED	---
EXISTING	---
LEGEND OF UNDERGROUND AND OVERHEAD UTILITIES	
AERIAL CABLE	---
ELECTRIC	---
TELEPHONE	---
GAS	---
SEWER	---
WATER	---
CABLE TV	---

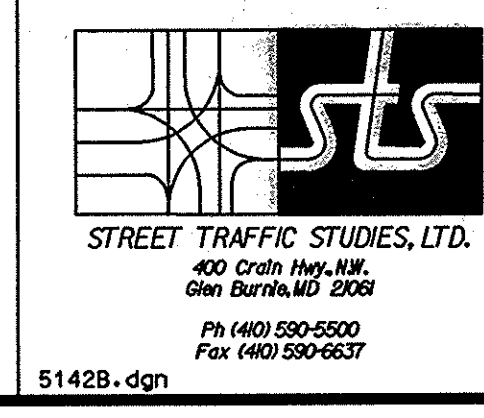

APPROVALS	
TEAM LEADER	
ASST. DIVISION CHIEF	
DIVISION CHIEF	
OFFICE DIRECTOR	

REVISIONS	
1	SHA: AT725185 6/06 INSTALL REDLINE VIDEO DETECTION
2	PROVIDE SIGNALIZATION FOR SALISBURY SPRING WORK ENT

STATE OF MARYLAND DEPARTMENT OF TRANSPORTATION STATE HIGHWAY ADMINISTRATION	
US 13 BUS AND DOGWOOD DRIVE	
TOD No.: AT725-08 SHA No.: W1366A51/B51	
SCALE 1"=20'	DATE 5/90
CONTRACT NO.	
DESIGNED BY M. ELAAOUAR	COUNTY WICOMICO
DRAWN BY T. SPECA	LOGMILE 22B01303.64
CHECKED BY EMM / D.D.	TMS NO. H426
F.A.P. NO.	TOD NO.
TS No. 2663B	DRAWING No. 2 OF 3
SHEET No. OF	

PLOTTED: \$DATE\$
FILE: \$FILE\$